

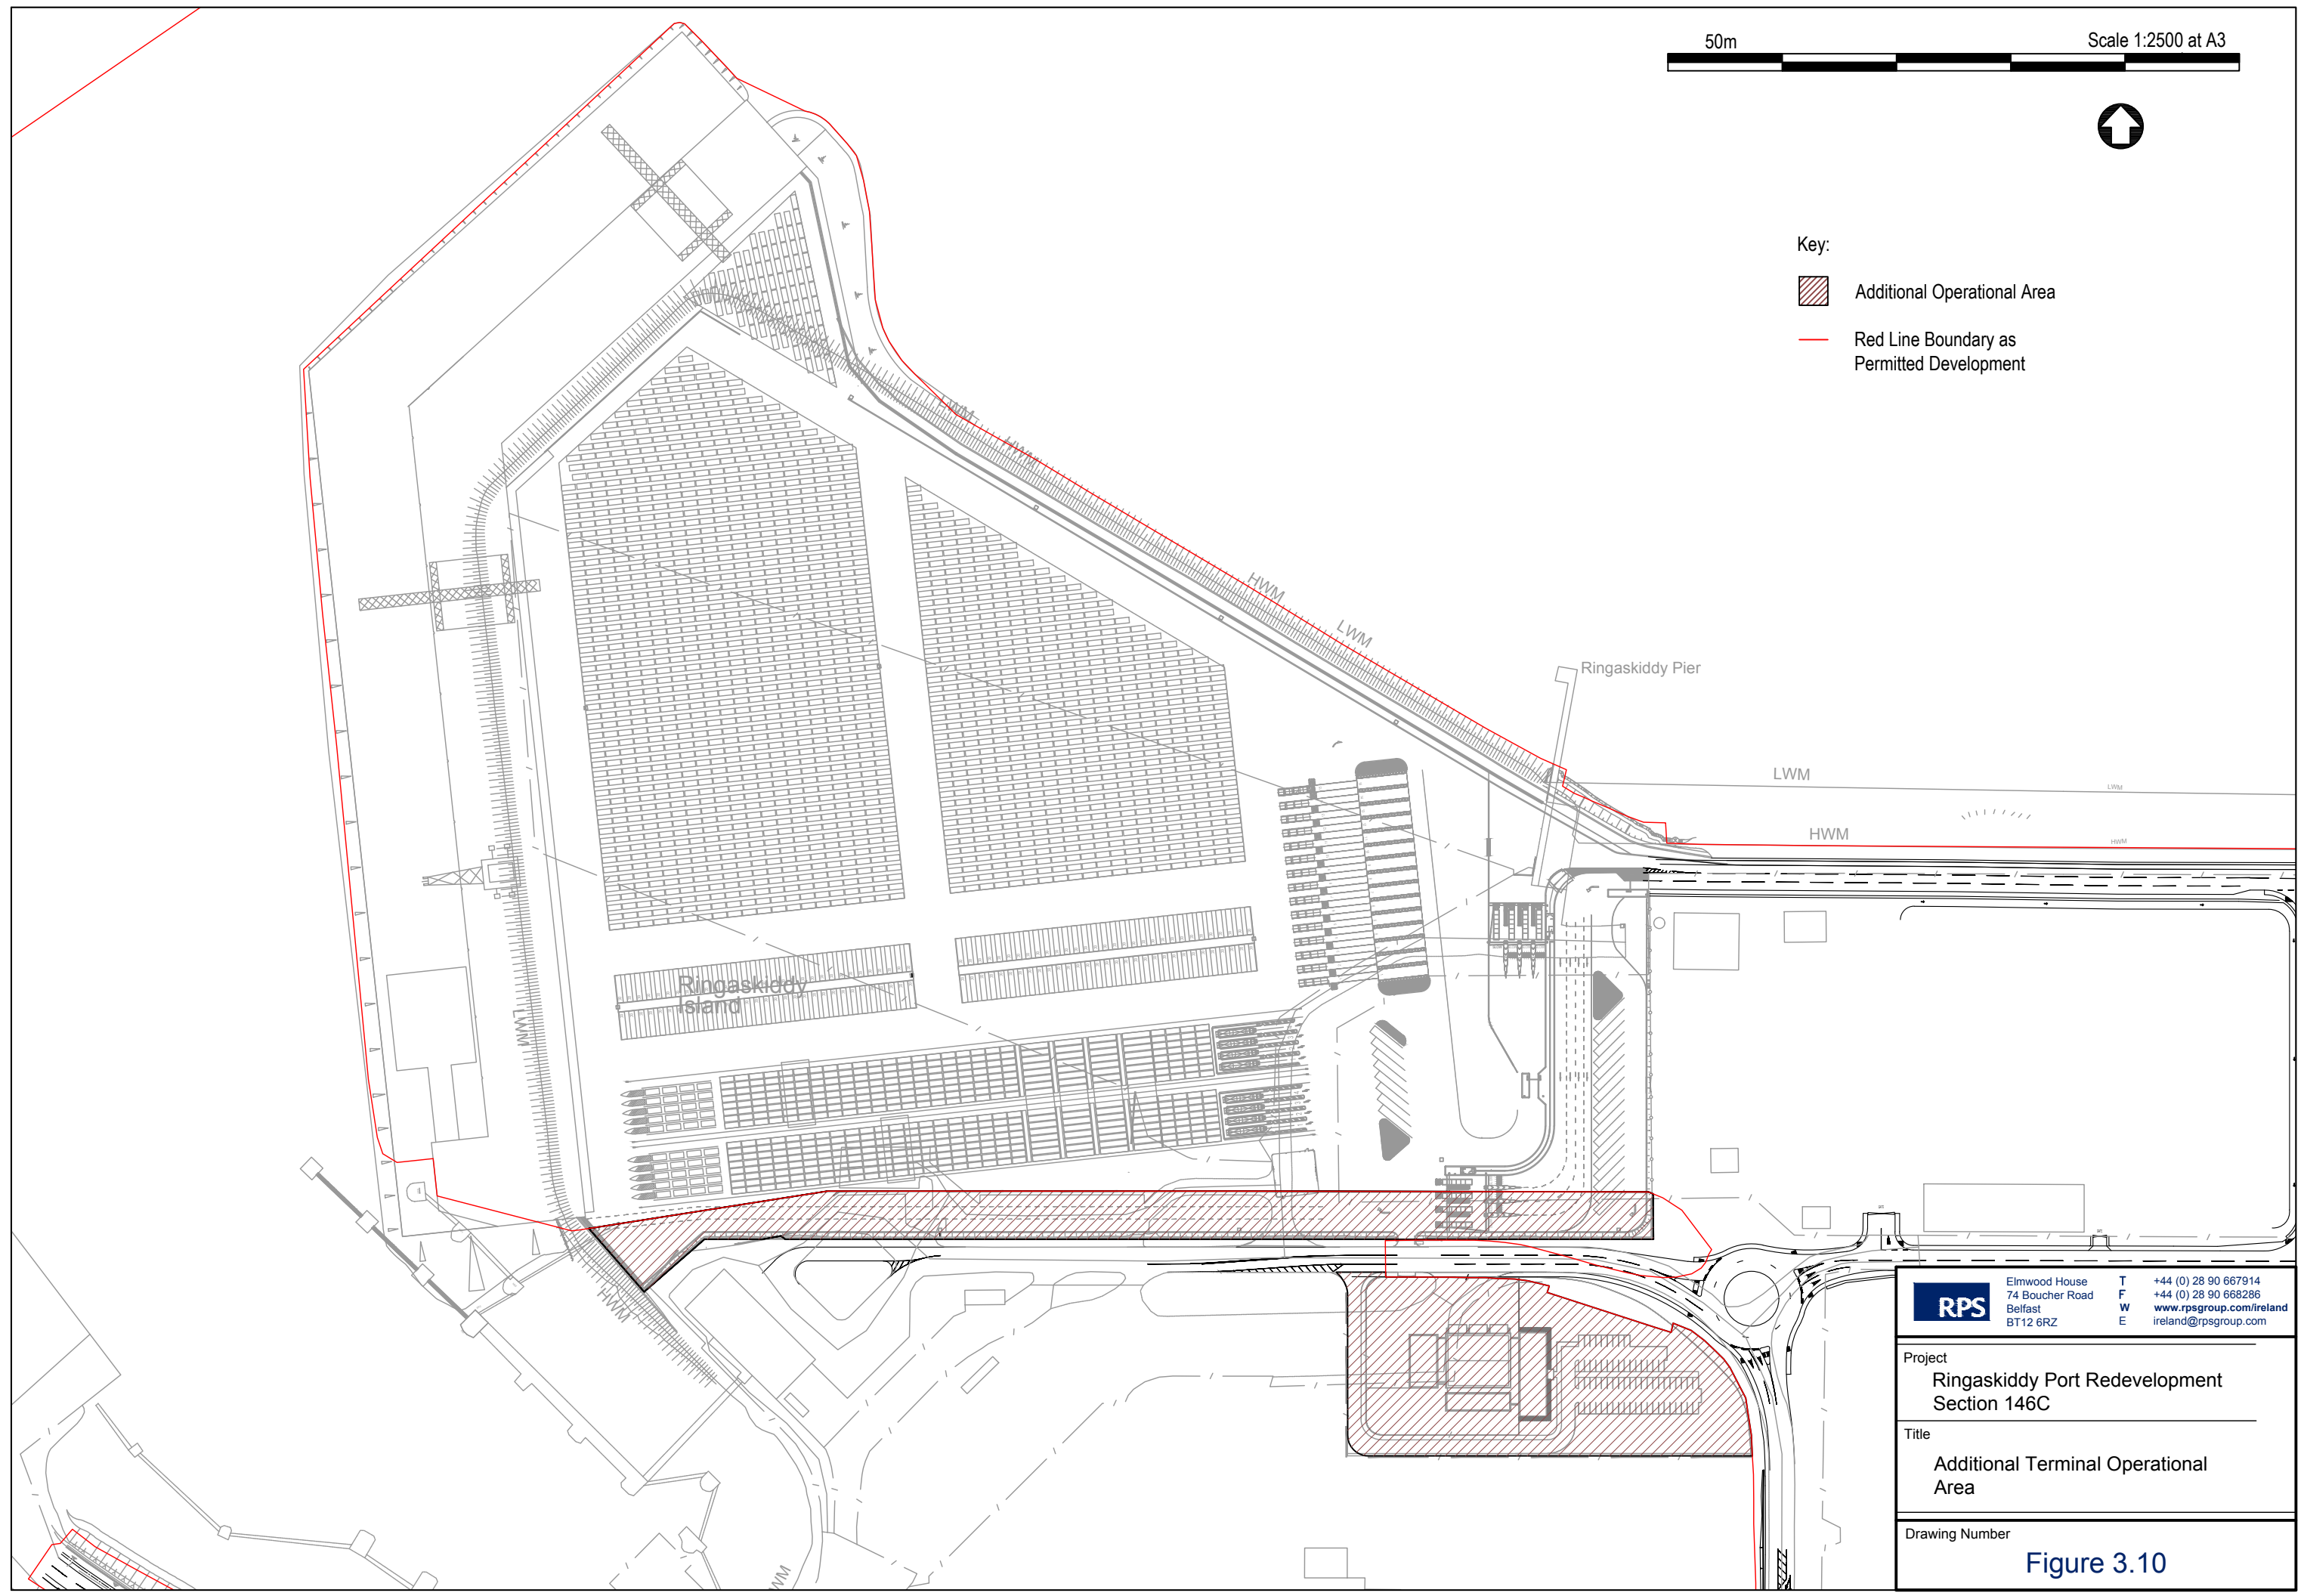




- Key:
-  Additional Operational Area
  -  Red Line Boundary as Permitted Development



**RPS** Elmwood House T +44 (0) 28 90 667914  
74 Boucher Road F +44 (0) 28 90 668286  
Belfast W www.rpsgroup.com/ireland  
BT12 6RZ E ireland@rpsgroup.com

Project  
Ringaskiddy Port Redevelopment  
Section 146C

Title  
Additional Terminal Operational  
Area

Drawing Number  
**Figure 3.10**