



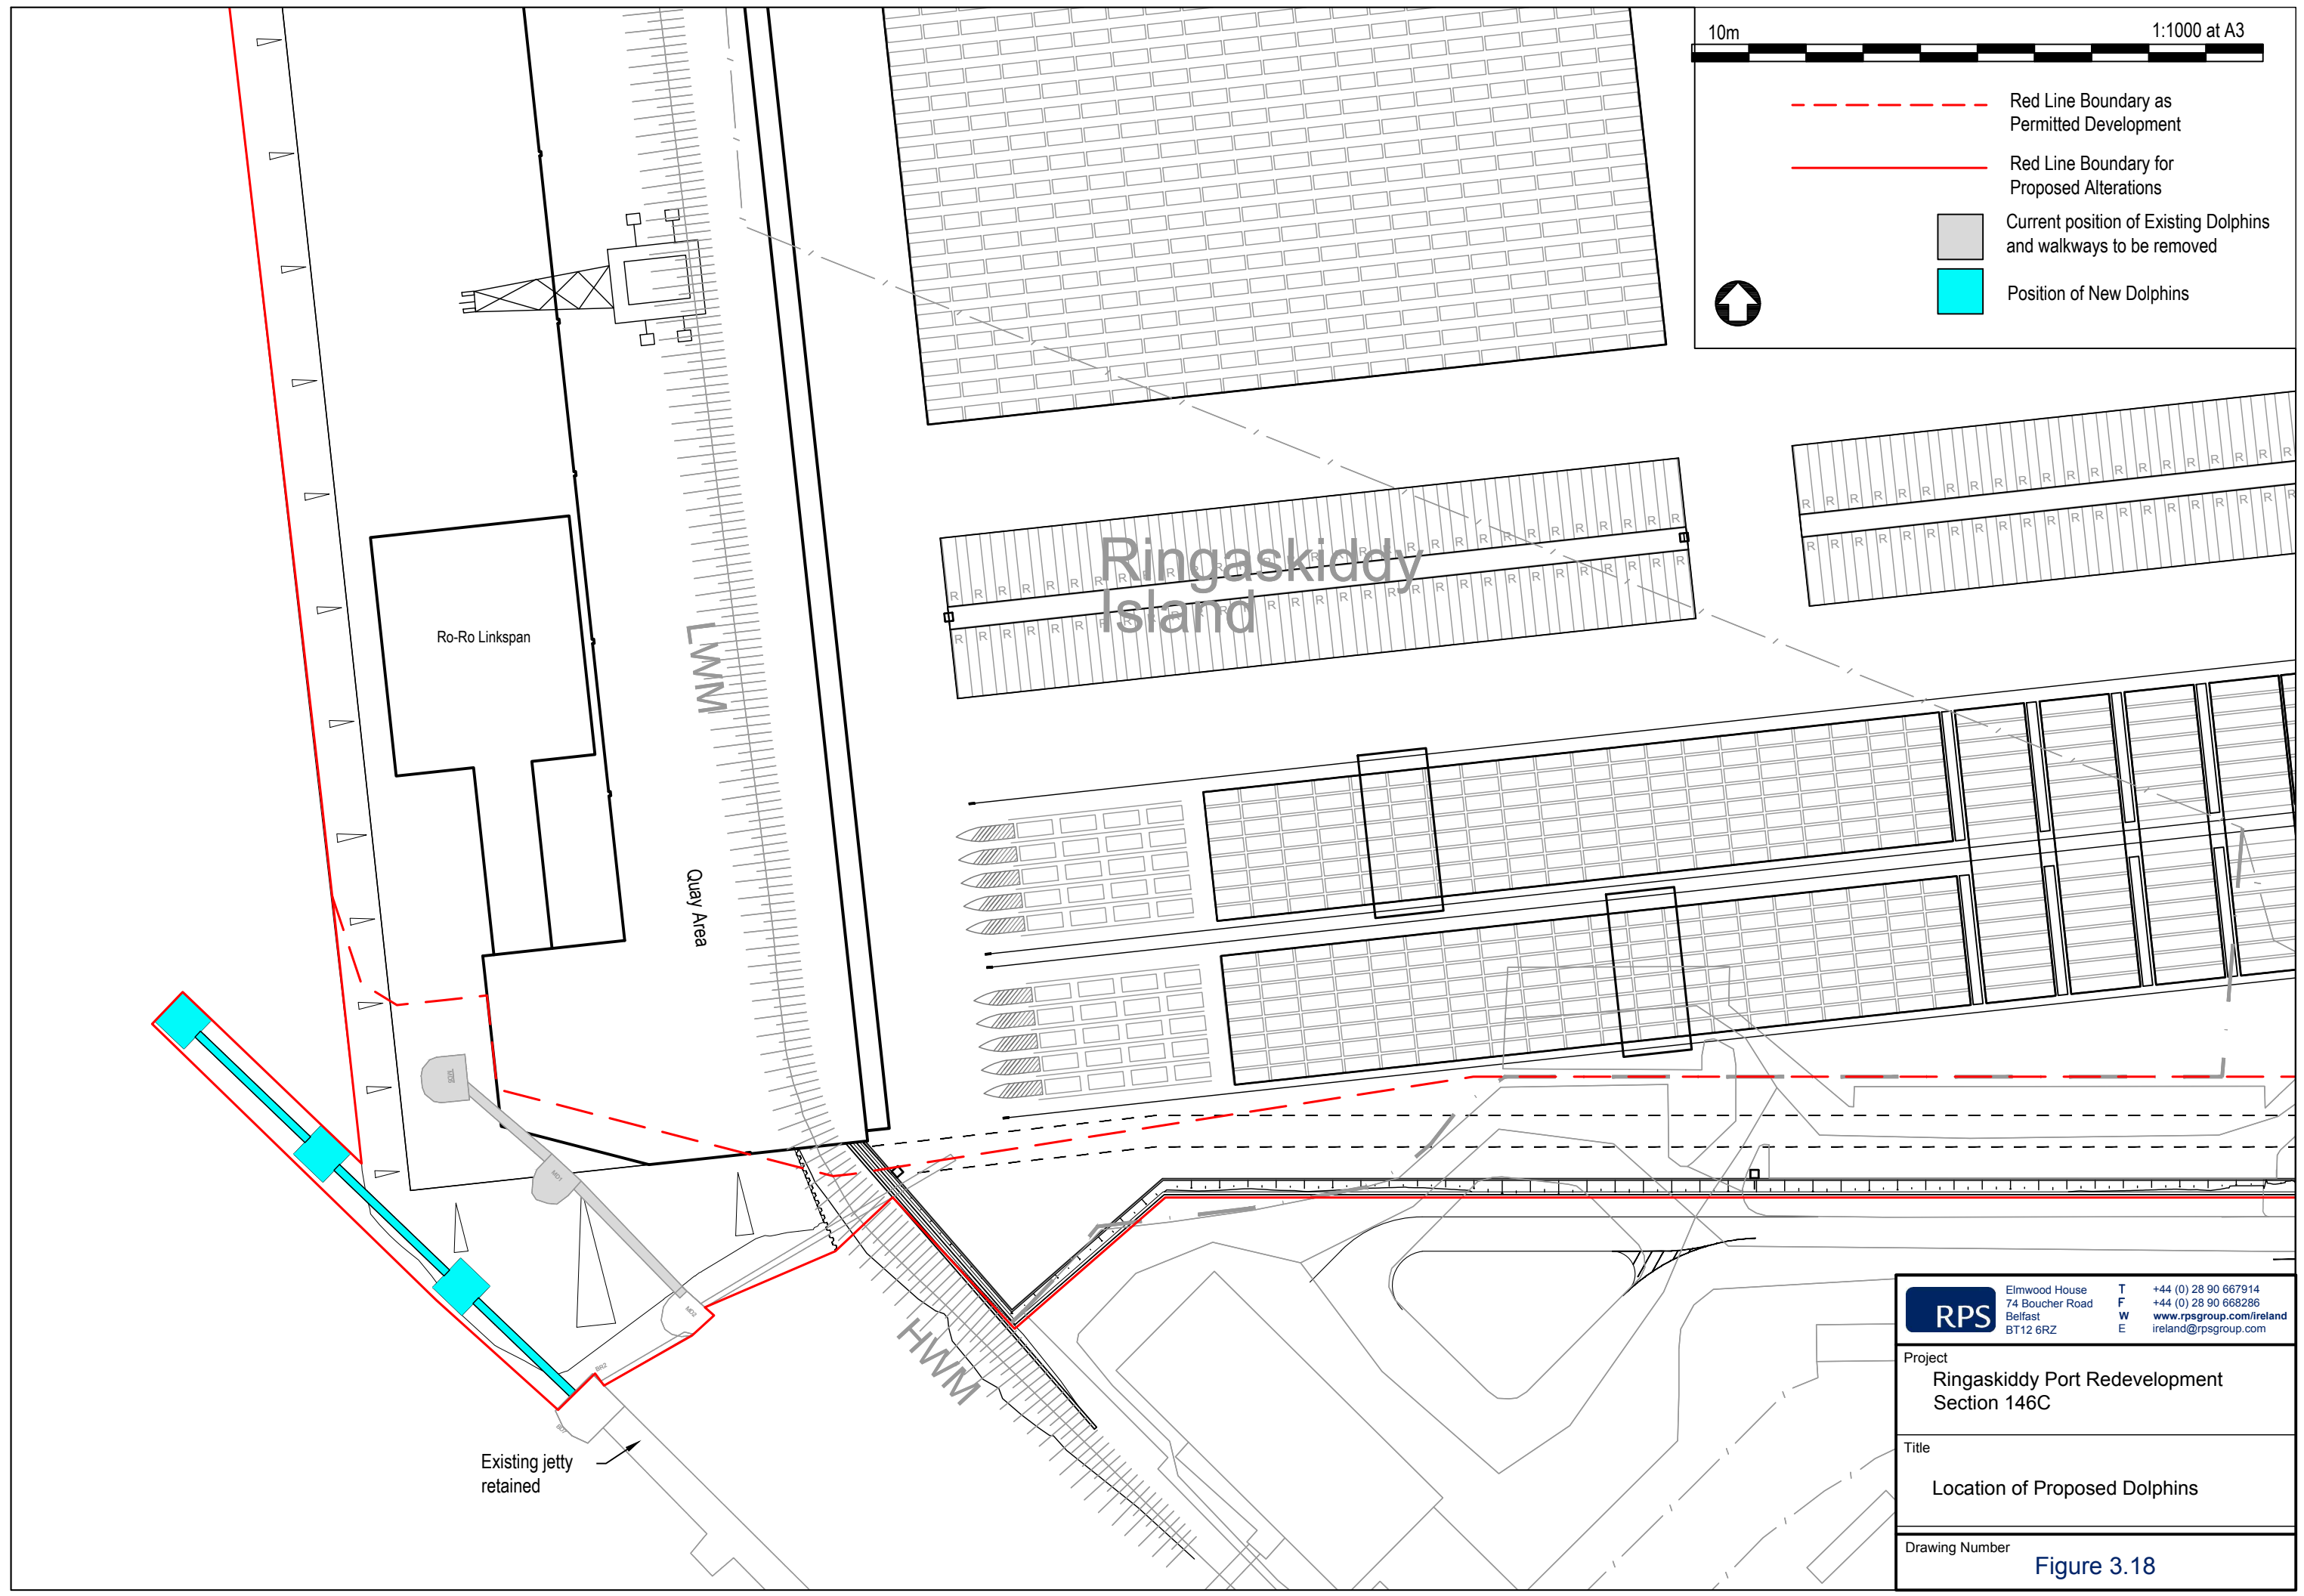


-  Red Line Boundary as Permitted Development
-  Red Line Boundary for Proposed Alterations
-  Current position of Existing Dolphins and walkways to be removed
-  Position of New Dolphins



RPS Elmwood House T +44 (0) 28 90 667914
 74 Boucher Road F +44 (0) 28 90 668286
 Belfast W www.rpsgroup.com/ireland
 BT12 6RZ E ireland@rpsgroup.com

Project
**Ringaskiddy Port Redevelopment
 Section 146C**

Title
Location of Proposed Dolphins

Drawing Number
Figure 3.18