



HARBOUR




Key:

 Area of Red Line Extension

 Red Line Boundary as per Permitted Development

 Red Line Boundary for Proposed Alterations

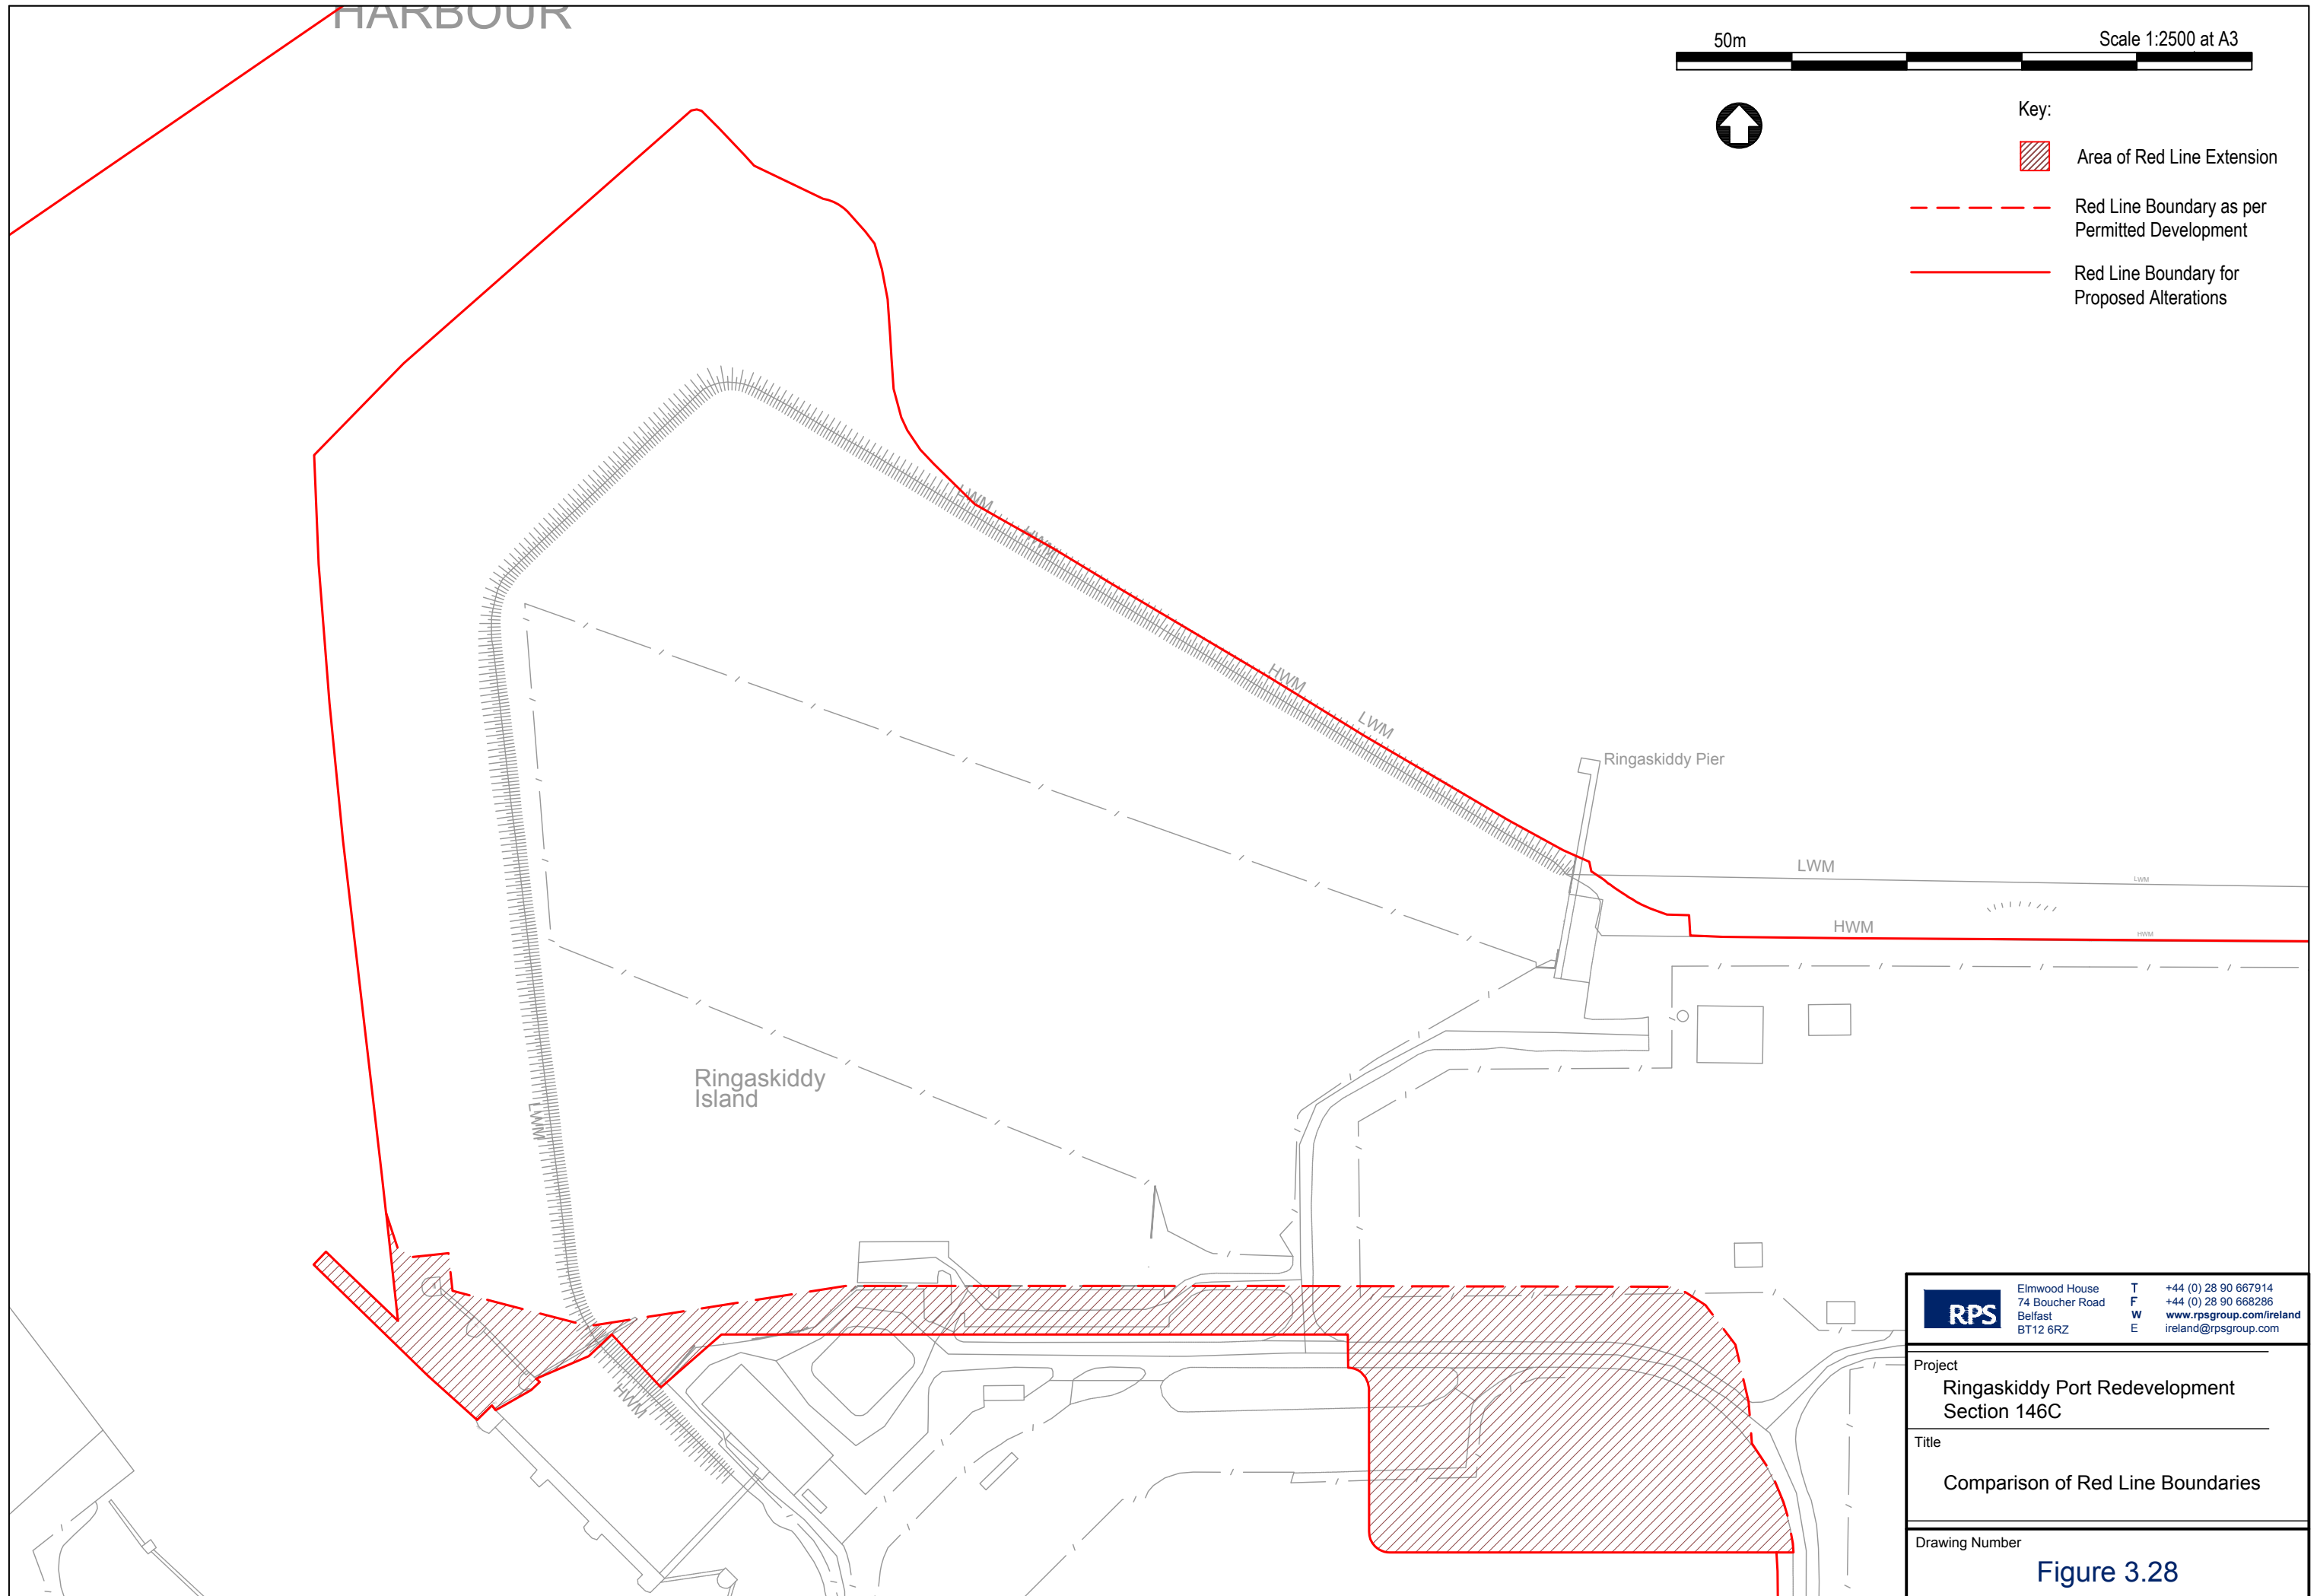

RPS Elmwood House T +44 (0) 28 90 667914
 74 Boucher Road F +44 (0) 28 90 668286
 Belfast W www.rpsgroup.com/ireland
 BT12 6RZ E ireland@rpsgroup.com

Project
Ringaskiddy Port Redevelopment
 Section 146C

Title
Comparison of Red Line Boundaries

Drawing Number
Figure 3.28