


- NOTES**
1. Verifying Dimensions.  
The contractor shall verify dimensions against such other drawings or site conditions as pertain to this part of the work.
  2. Existing Services.  
Any information concerning the location of existing services indicated on this drawing is intended for general guidance only. It shall be the responsibility of the contractor to determine and verify the exact horizontal and vertical alignment of all cables, pipes, etc. (both underground and overhead) before work commences.
  3. Issue of Drawings.  
Hard copies, dwf and pdf will form a controlled issue of the drawing. All other formats (dwg, dxf etc.) are deemed to be an uncontrolled issue and any work carried out based on these files is at the recipient's own risk. RPS will not accept any responsibility for any errors arising from the use of these files, either by human error by the recipient, listing of un-dimensioned measurements, compatibility issues with the recipient's software, and any errors arising when these files are used to aid the recipient's drawing production, or setting out on site.
  4. DATUM: Ordnance Datum Poolbeg
  5. PORT OF CORK COMPANY  
ORDNANCE SURVEY IRELAND  
LICENCE No. EN 0040614  
© ORDNANCE SURVEY IRELAND/  
GOVERNMENT OF IRELAND
  6. MAP TILE REF: 6472-20, 6472-19, 6472-C and 6472-D
  7. For details on Elevation A-A refer to IBM0575-PL-0012
  8. For clarity the Quay Layout is illustrated for Phase 1a for which the additional dredging is required to accommodate mooring along the full length of the Berth 1

- Key:**
- Red Line Boundary as per Permitted Development
  - Red Line Boundary for Proposed Alterations
  - Ownership Boundary
  - Area of Revised Planning
  - Extended Dredge basin to accommodate berthing on full quay length in Phase 1

<b>D</b>	Drawing updated	M.H.	09/12/2016
<b>C</b>	Drawing updated.	M.H.	05/12/2016
<b>B</b>	Drawing updated to suit amended layout Text and dimensions added Drawing status amended	M.H.	04/11/2016
<b>A</b>	PoC Freehold Boundary Added	CV	14/04/2016
rev	amendments	drawn	date

**RPS** Elmwood House T +44 (0) 28 90 667914  
74 Boucher Road F +44 (0) 28 90 668286  
Belfast W www.rpsgroup.com/ireland  
BT12 6RZ E ireland@rpsgroup.com

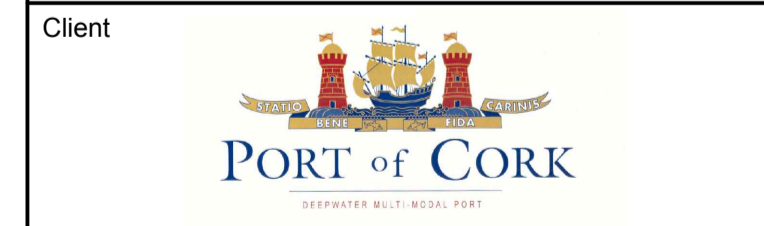

Client  
**PORT of CORK**  
Project  
**Ringaskiddy Port Redevelopment  
Section 146C**

Title  
**Proposed Dolphins**

Drawing Status	Sheet Size	Drawing Scale	
Planning	A1	1:500	
Drawing Number	Rev <b>D</b>		
<b>IBM0575-PL-0005</b>			
Project Leader	Drawn By	Date	Initial Review
DR	PM	03/16	DR