


10m SCALE 1:500


- NOTES**
- Verifying Dimensions. The contractor shall verify dimensions against such other drawings or site conditions as pertain to this part of the work.
 - Existing Services. Any information concerning the location of existing services indicated on this drawing is intended for general guidance only. It shall be the responsibility of the contractor to determine and verify the exact horizontal and vertical alignment of all cables, pipes, etc. (both underground and overhead) before work commences.
 - Issue of Drawings. Hard copies, dwf and pdf will form a controlled issue of the drawing. All other formats (dwg, dxf etc.) are deemed to be an uncontrolled issue and any work carried out based on these files is at the recipient's own risk. RPS will not accept any responsibility for any errors arising from the use of these files, either by human error by the recipient, listing of un-dimensioned measurements, compatibility issues with the recipient's software, and any errors arising when these files are used to aid the recipient's drawing production, or setting out on site.
 - DATUM: Ordnance Datum Poolbeg
 - PORT OF CORK COMPANY
ORDNANCE SURVEY IRELAND
LICENCE No. EN 0040614
© ORDNANCE SURVEY IRELAND/
GOVERNMENT OF IRELAND
 - MAP TILE REF: 6472-20, 6472-19, 6472-C and 6472-D

- Key:**
- Red Line Boundary as per Permitted Development
 - Red Line Boundary for Proposed Alterations
 - Ownership Boundary
 - Area of Revised Planning
 - Port of Cork Freehold Boundary, under 1994 conveyance
 - Phase 1a
 - Phase 1b

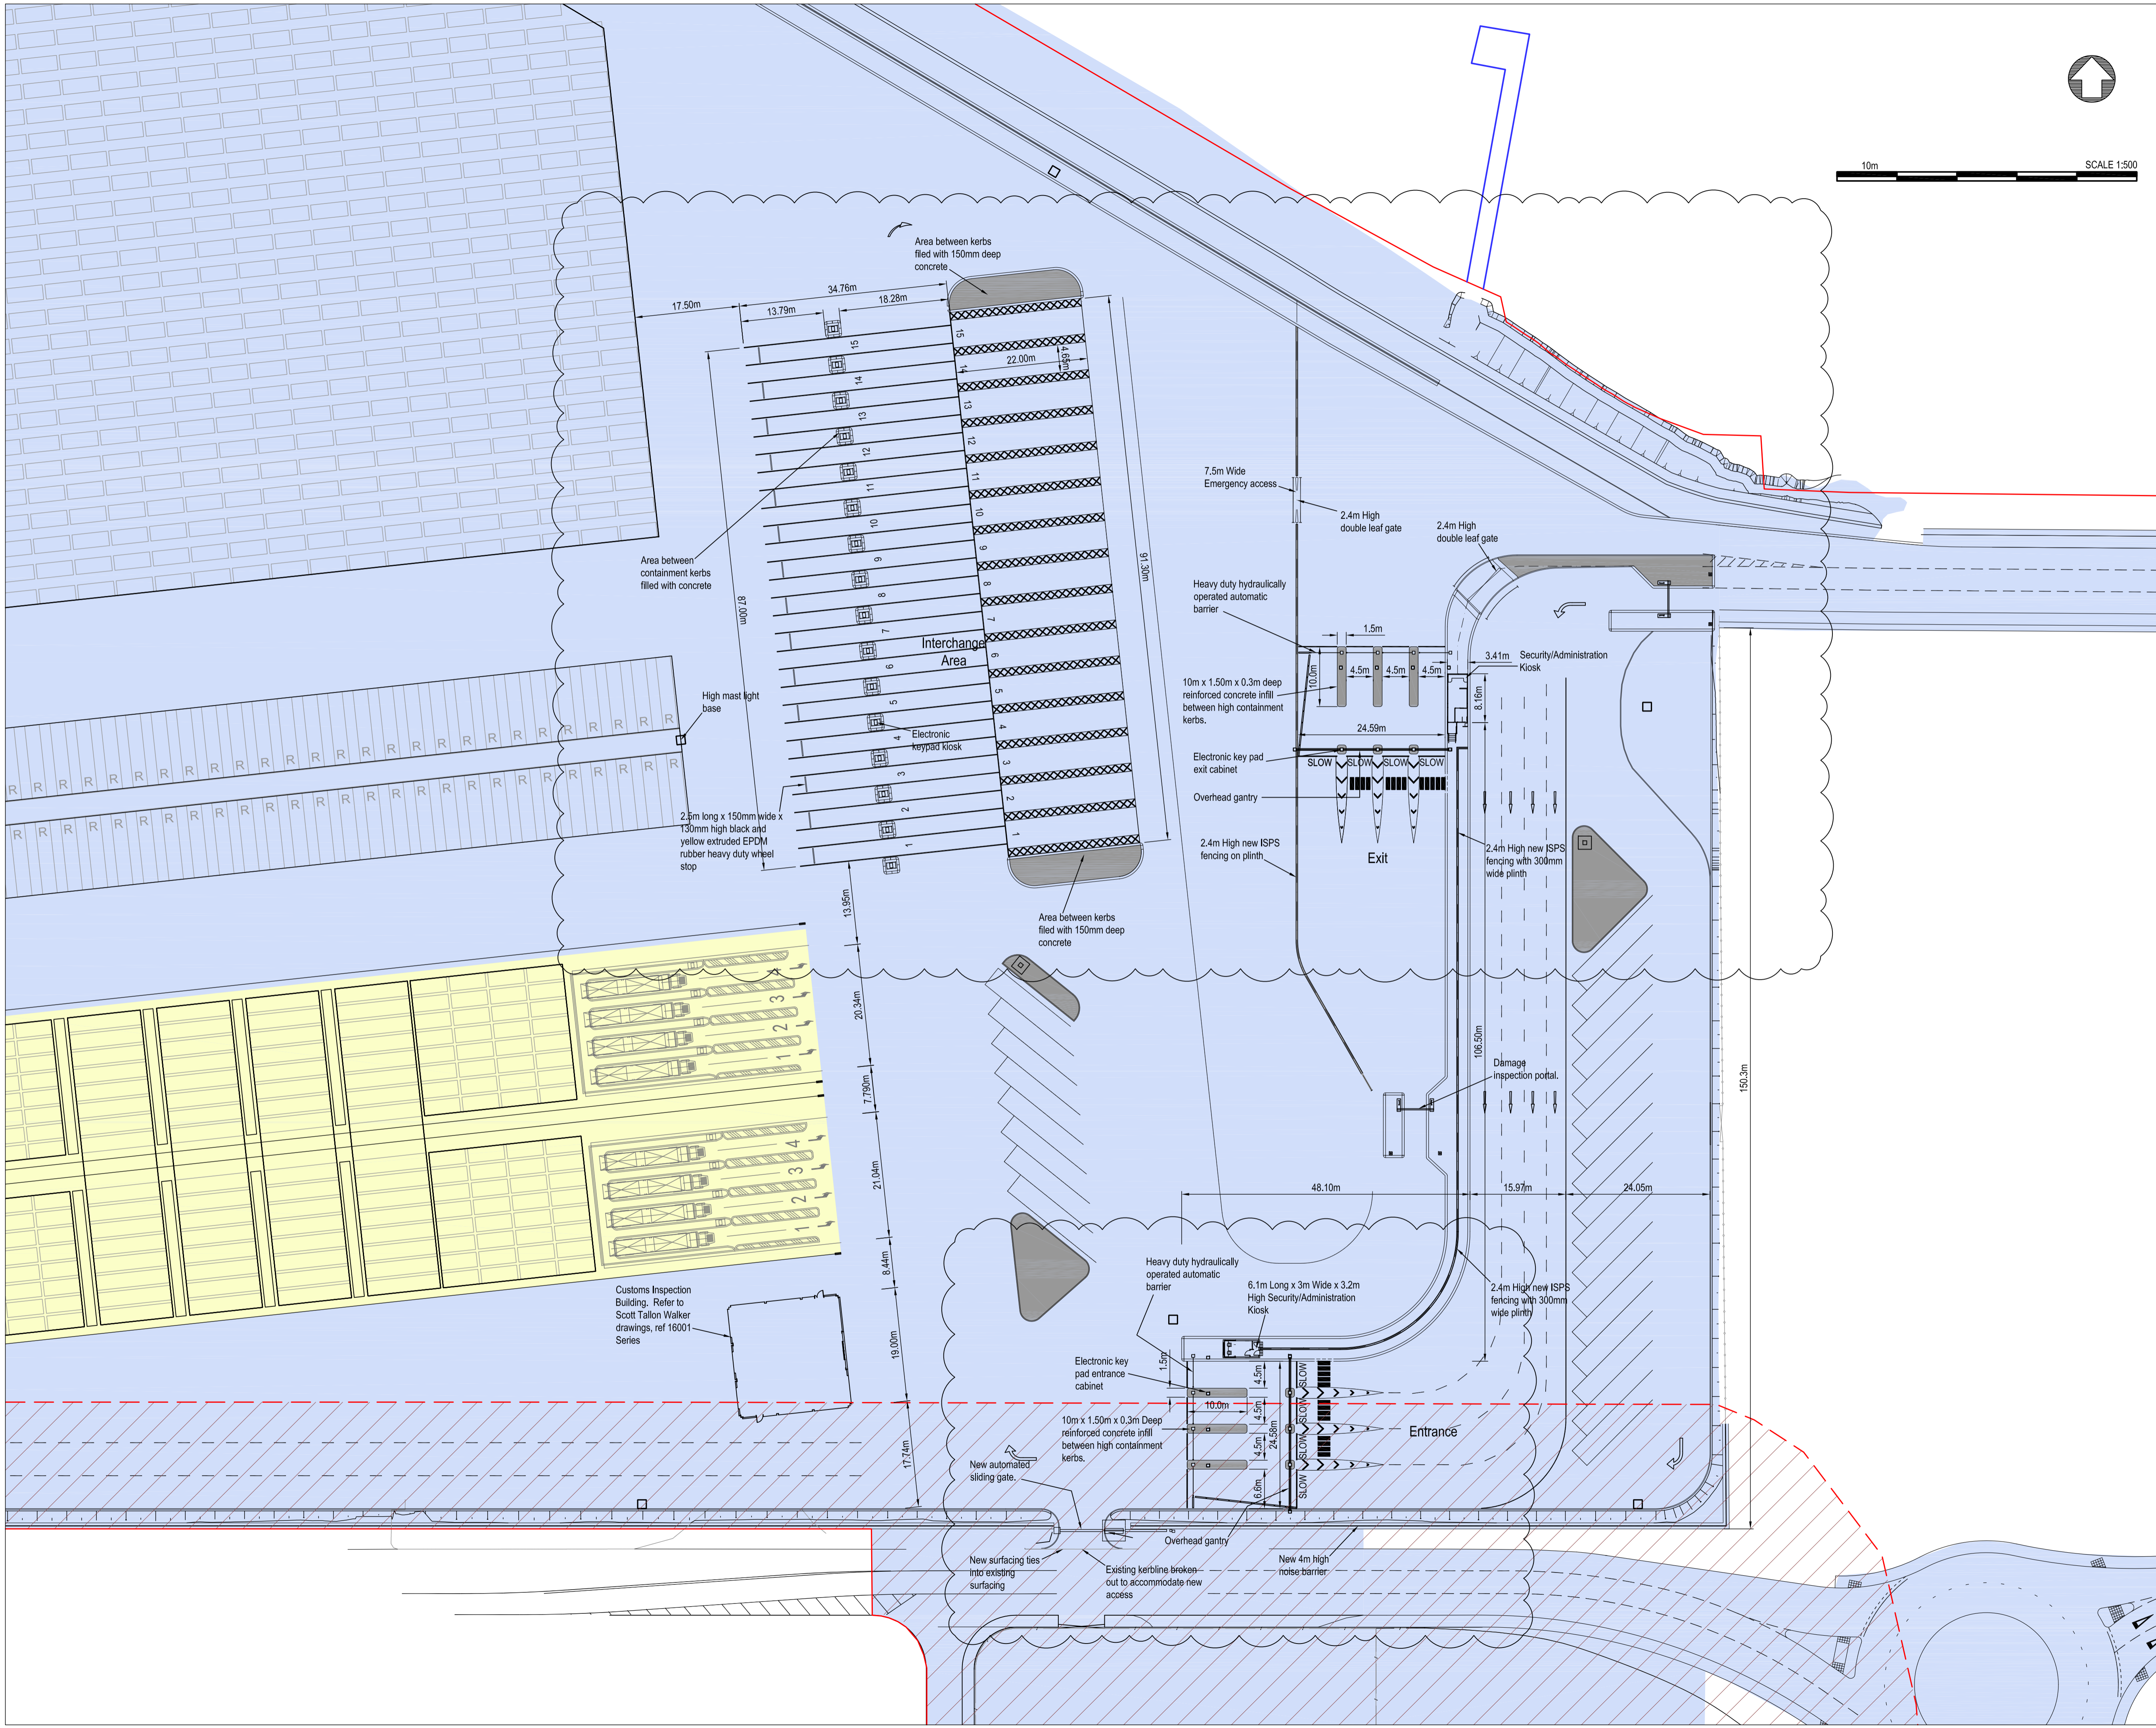

D	Drawing updated	M.H.	09/12/2016
C	Drawing updated Drawing status changed	M.H.	07/11/2016
B	Customs Building Updated	PM	14/07/2016
A	Drawing Renumbered	PM	18/05/2016
rev	amendments	drawn	date

RPS Elmwood House T +44 (0) 28 90 667914
74 Boucher Road F +44 (0) 28 90 668286
Belfast W www.rpsgroup.com/ireland
BT12 6RZ E ireland@rpsgroup.com

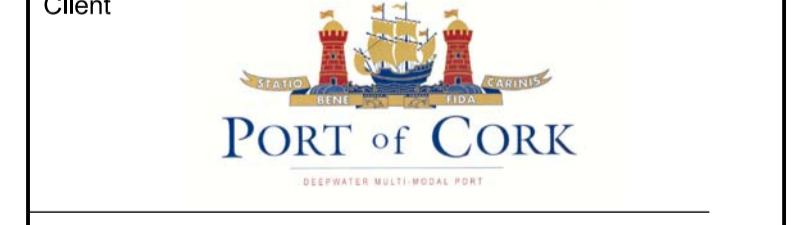

Client
Project
Ringaskiddy Port Redevelopment
Section 146C

Title
Entrance and Revised
Interchange and Exit Area

Drawing Status	Sheet Size	Drawing Scale
Planning	A1	1:500

Drawing Number	Rev
IBM0575-PL-0008	D

Project Leader	Drawn By	Date	Initial Review
DR	PM	03/16	DR