


- NOTES**
- Verifying Dimensions.**
The contractor shall verify dimensions against such other drawings or site conditions as pertain to this part of the work.
 - Existing Services.**
Any information concerning the location of existing services indicated on this drawing is intended for general guidance only. It shall be the responsibility of the contractor to determine and verify the exact horizontal and vertical alignment of all cables, pipes, etc. (both underground and overhead) before work commences.
 - Issue of Drawings.**
Hard copies, dxf and pdf will form a controlled issue of the drawing. All other formats (dwg, dxf, etc.) are deemed to be uncontrolled issue and any work carried out based on these files is at the recipient's own risk. RPS will not accept any responsibility for any errors arising from the use of these files, either by human error by the recipient, listing of un-dimensioned measurements, compatibility issues with the recipient's software, and any errors arising when these files are used to add the recipient's drawing production, or setting out on site.
 - DATUM:** Ordnance Datum Poolbeg
 - PORT OF CORK COMPANY**
ORDNANCE SURVEY IRELAND
LICENCE No. EN 0048214
© ORDNANCE SURVEY IRELAND/
GOVERNMENT OF IRELAND
 - MAP TILE REF:** 6472-20, 6472-19, 6472-C and 6472-D
 - For details on Section A-A and B-B refer to IBM0575-PL-0003 and 0004**
 - For details on Section C-C and D-D refer to IBM0575-PL-0011**

- Key:**
- Red Line Boundary as per Permitted Development
 - Red Line Boundary for Proposed Alterations
 - Ownership Boundary
 - Area of Revised Planning
 - Extended Dredge basin to accommodate berthing on full quay length

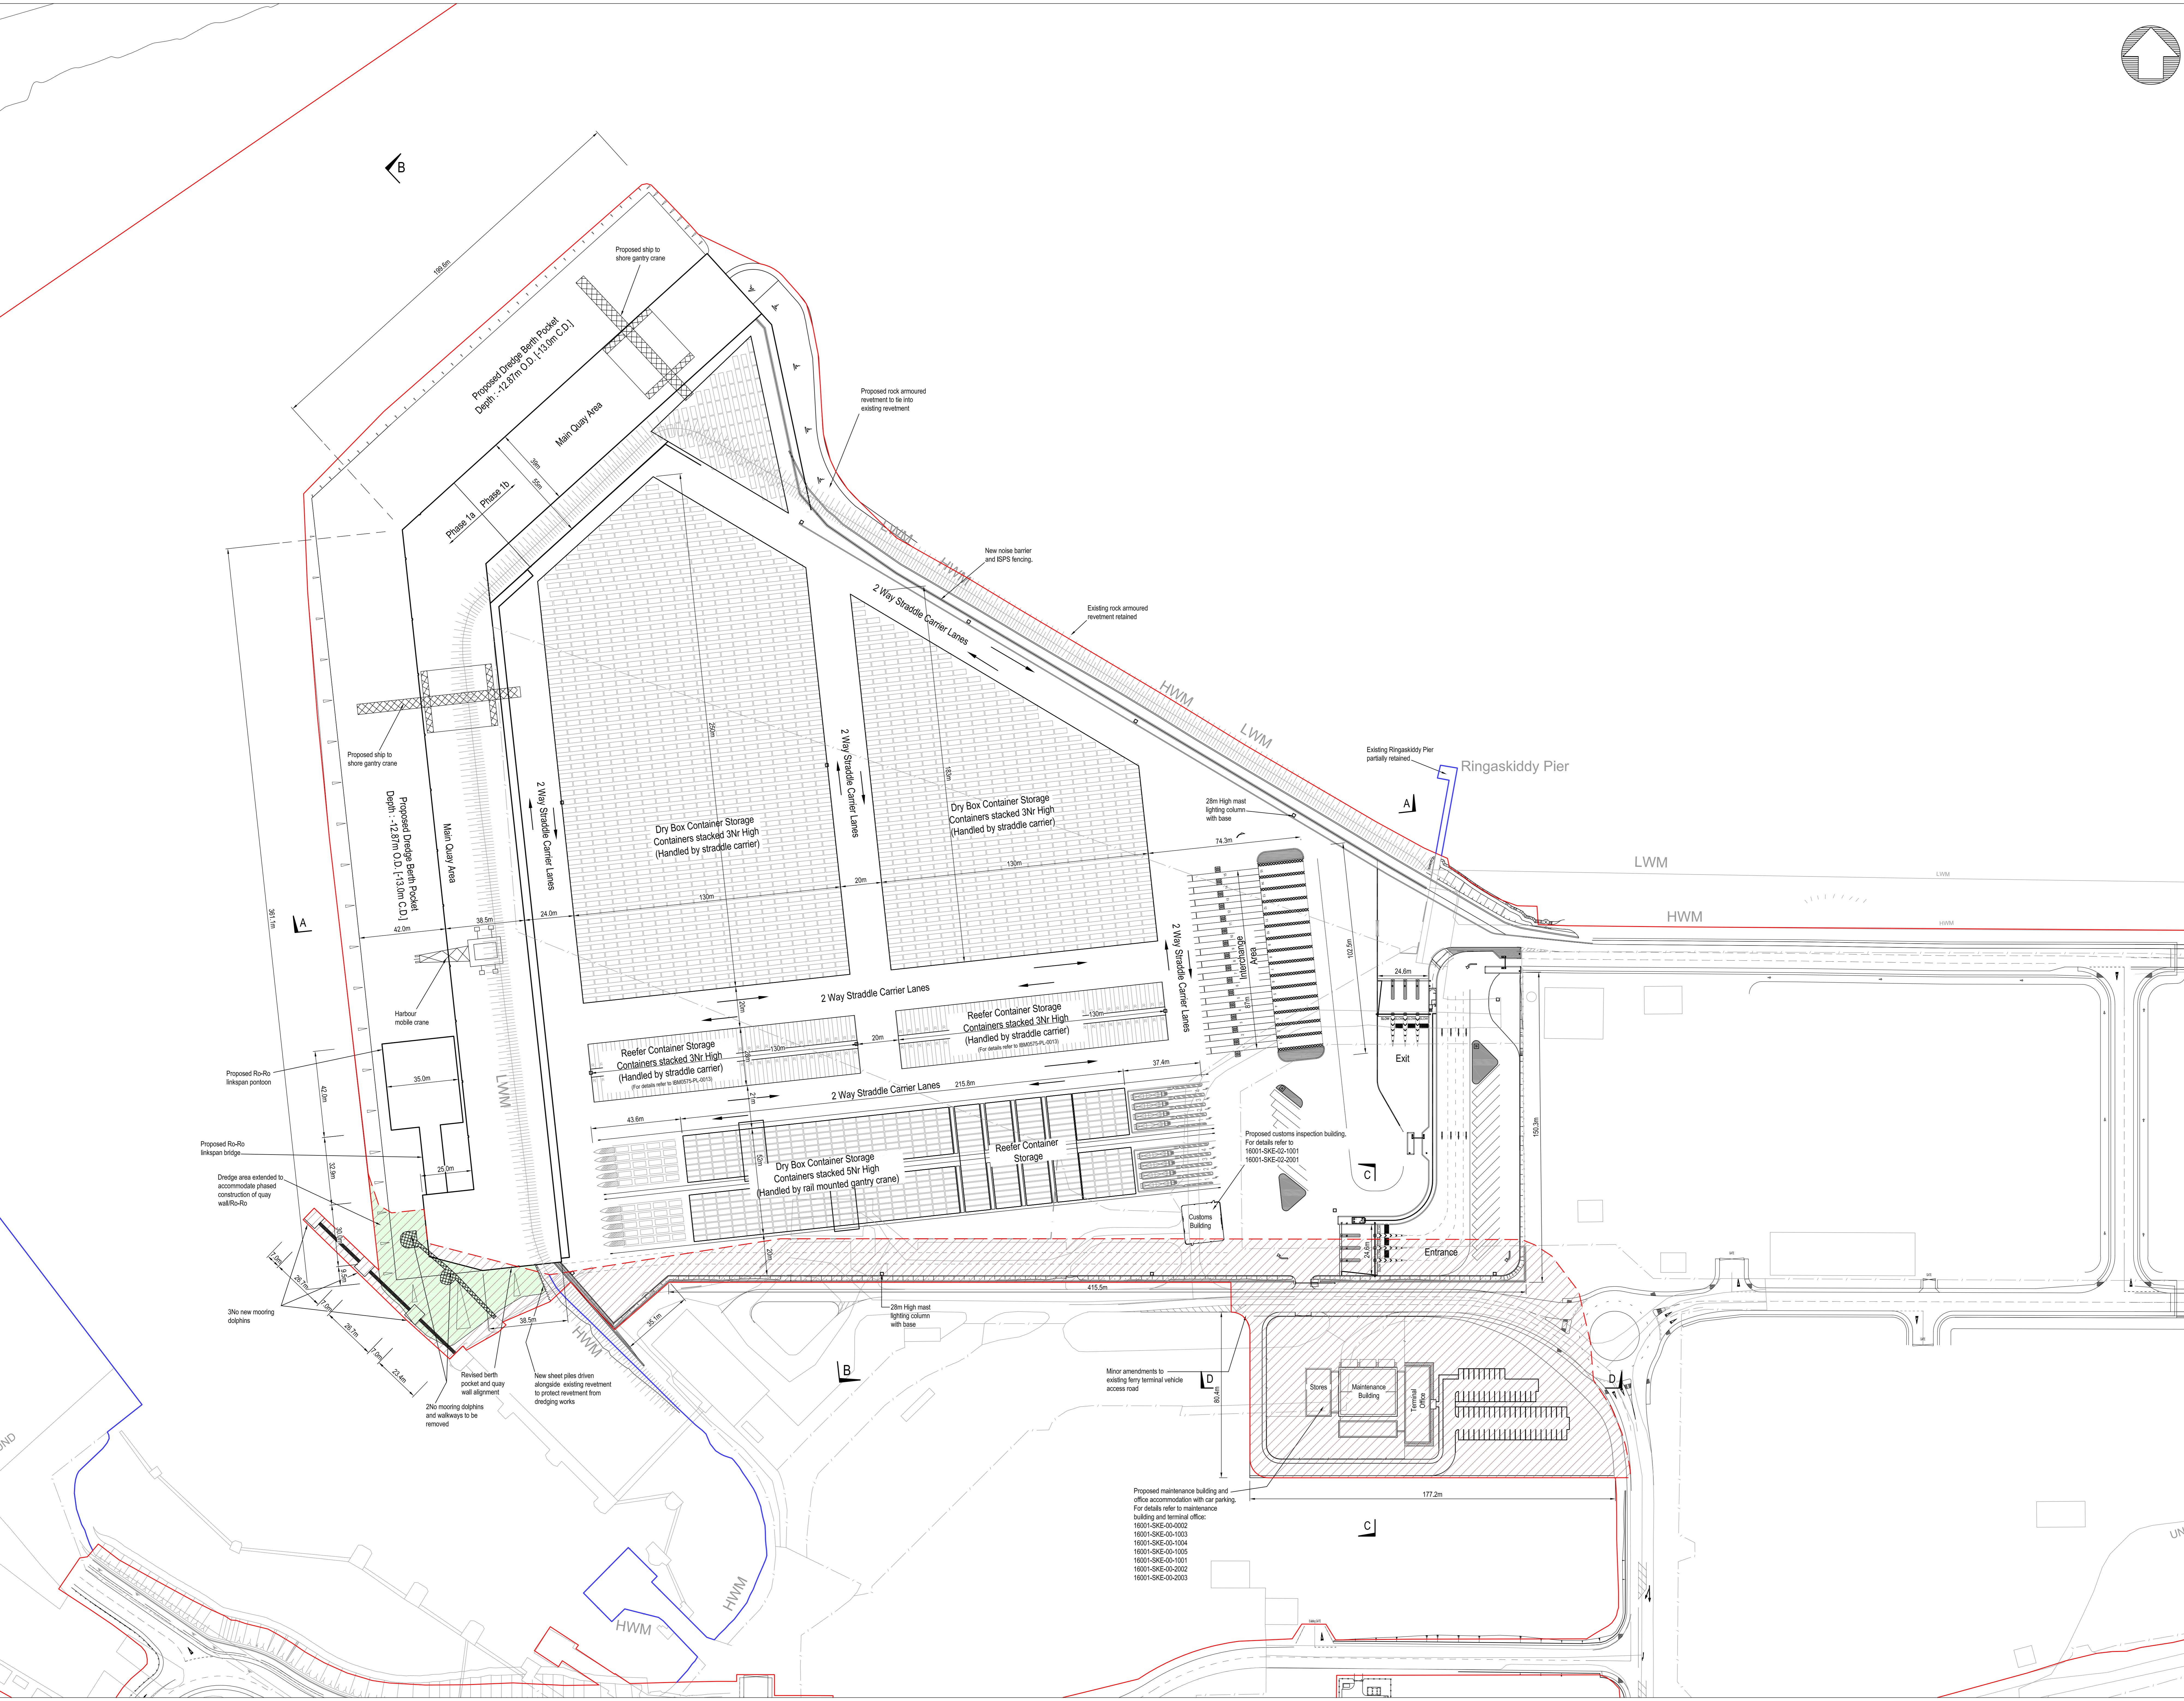

D	Drawing updated	M.H.	09/12/2016
C	Drawing updated	M.H.	05/12/2016
B	Drawing updated to suit current layout Drawing title amended	M.H.	03/11/2016
A	Customs Building Updated	PM	14/07/2016
rev	amendments	drawn	date

RPS
Elmwood House
74 Boucher Road
Belfast
BT12 6PC

Tel: +44 (0) 28 90 667914
Fax: +44 (0) 28 90 666086
www.rpsgroup.com/ireland
ireland@rpsgroup.com

Client

PORT OF CORK
A member of the RPS Group

Project
Ringaskiddy Port Redevelopment
Section 146C

Title
Revised Container Terminal Plan

Drawing Status Planning	Sheet Size A0	Drawing Scale 1:1000
Drawing Number IBM0575-PL-0002	Rev D	
Project Leader DR	Drawn By PM	Date 03/2016
Initial Review DR		

Proposed maintenance building and office accommodation with car parking.
For details refer to maintenance building and terminal office:
